



Valley Oak Redlined Site Plan

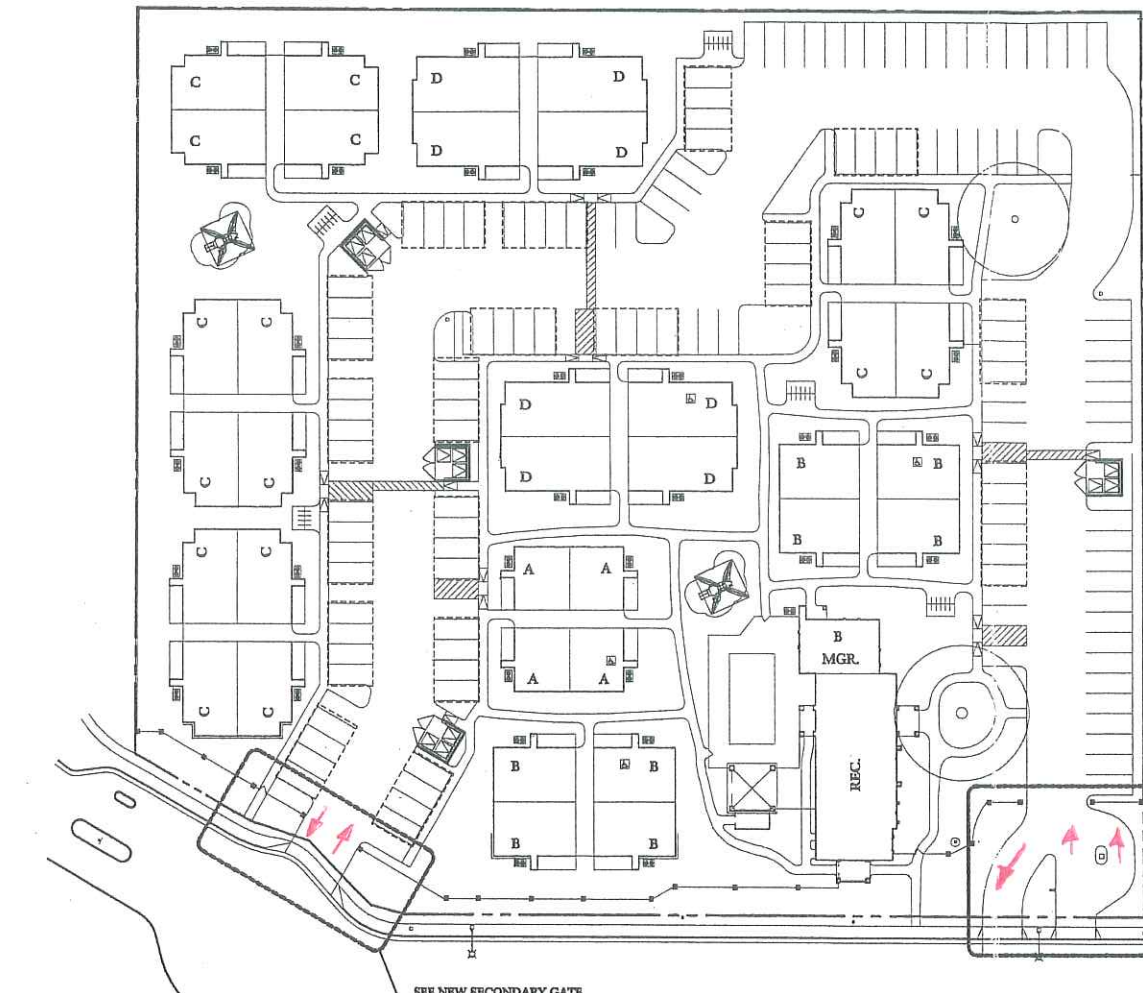

SITE ADDRESS : 1165 HANFORD ARMONA ROAD, LEMOORE CA. 93245


EXISTING SITE PLAN

SCALE: 1/4" = 30'-0"

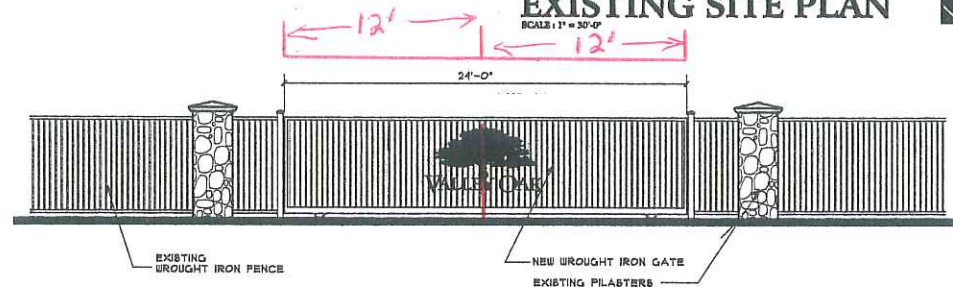


NEW MAIN ENTRY GATE ELEVATION

SCALE: 1/4" = 1'-0"

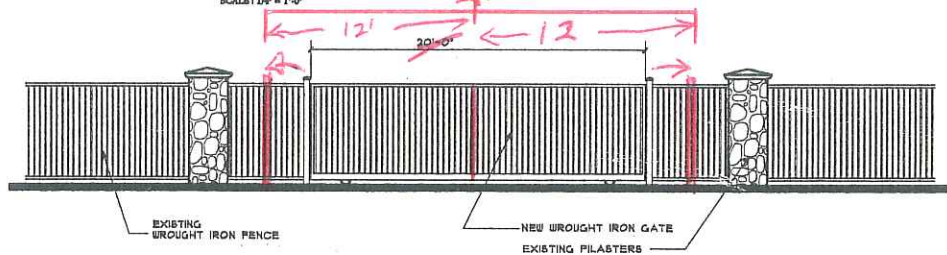

NEW SECONDARY GATE ELEVATION

SCALE: 1/4" = 1'-0"

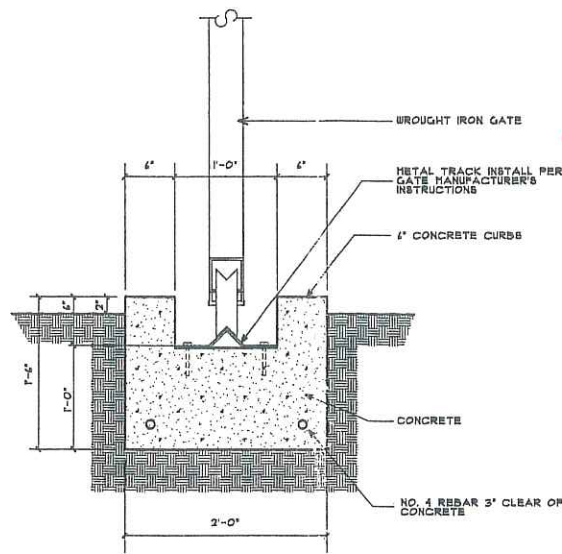


DETAIL

SCALE: 1" = 1'-0"


NEW MAIN ENTRY GATE

SCALE: 1/4" = 1'-0"

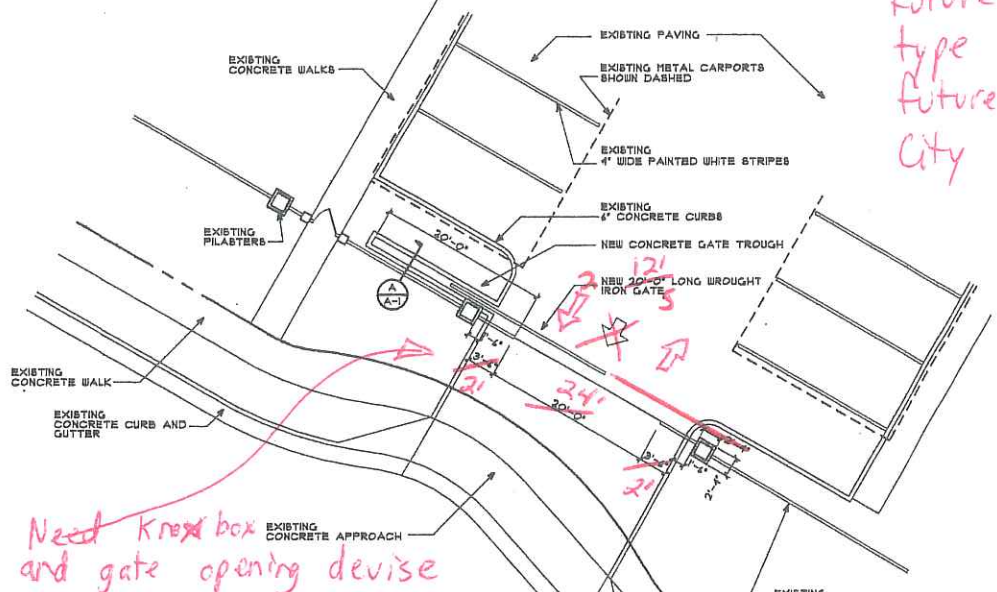

NEW SECONDARY GATE

SCALE: 1/4" = 1'-0"

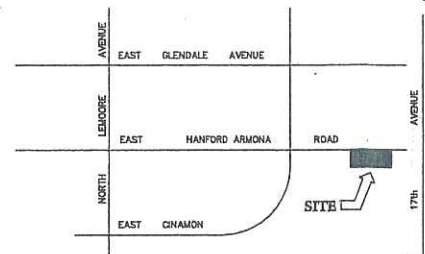

VINCINITY MAP

REVISIONS	
△	
△	
△	

* Incorporate wiring for future 3M Stroke Opticom type technology for future installation when city technology in place



Welter Inc. architects, inc.

1750 N. Blvd. Suite B
Fresno, Ca 93711
554-214-0900

DATE: DEC. 15 2001
JOB NO. 0155

A-1
OF SHEETS